


As Approved/As Proposed Elevation E01
Scale 1:100

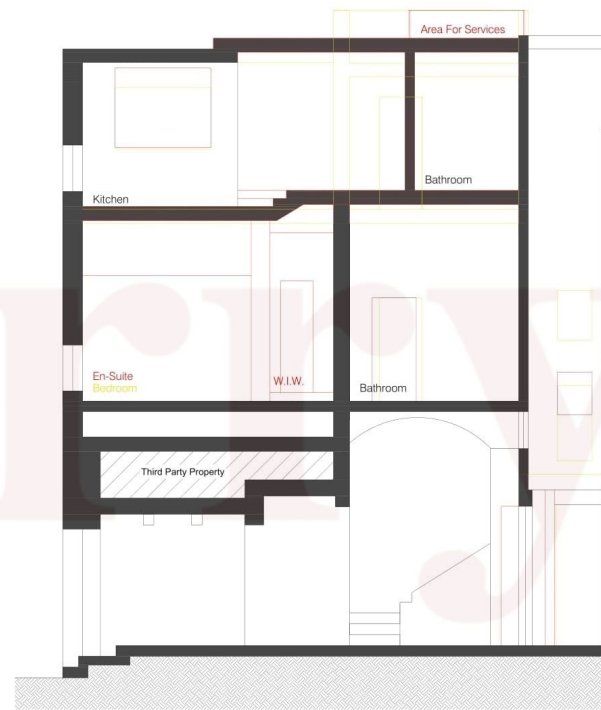

As Approved/As Proposed Section S01
Scale 1:100


- LEGEND**
- construction proposed
 - demolition proposed
 - as constructed, to sanction
 - approved but not constructed, to sanction

- MATERIALS**
1. Facade in limestone, 'luq il-fil'.
 2. Facade in HCB, rendered in stone colour.
 3. Apertures in timber, painted.
 4. Main door in timber, painted.
 5. Railings in wrought iron, painted.


NOTES

10
8
6
5
4
3
2
1
0

0 1 2 3 4 5 6 8 10m Scale 1:100

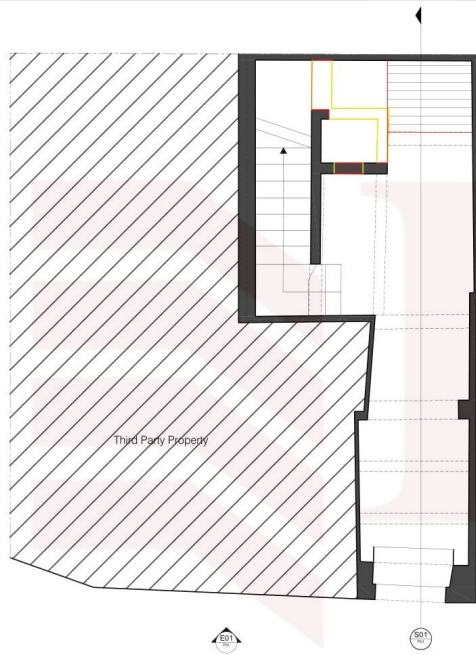


As Approved/As Proposed Ground Floor Plan
Scale 1:100

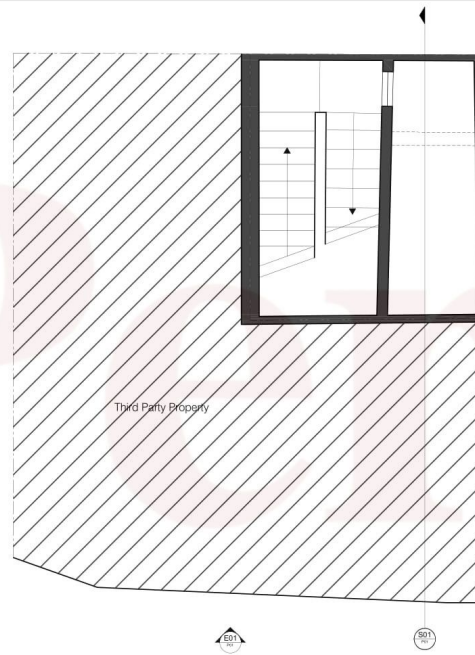


As Approved/As Proposed Intermediate Floor Plan
Scale 1:100



As Approved/As Proposed First Floor Plan
Scale 1:100

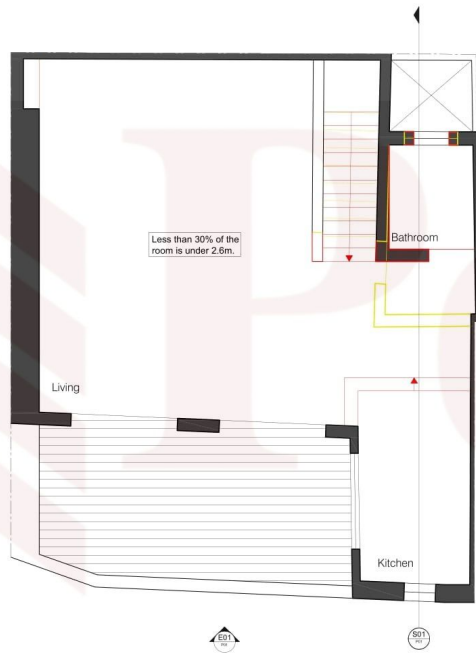

As Approved/As Proposed Lower Roof Floor Plan
Scale 1:100

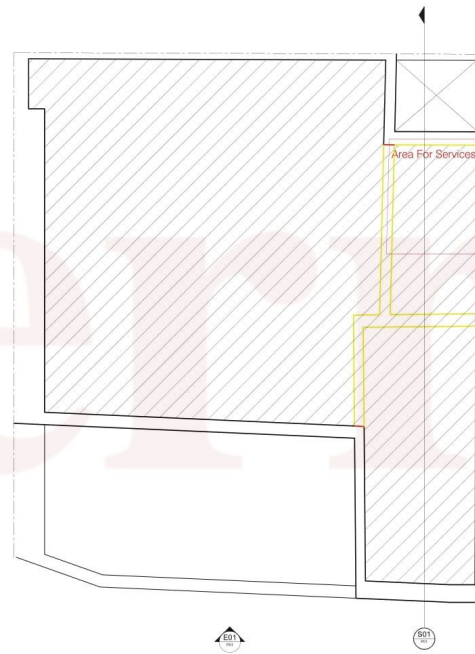

As Approved/As Proposed Upper Roof Floor Plan
Scale 1:100

- LEGEND**
- construction proposed
 - demolition proposed
 - as constructed, to sanction
 - approved but not constructed, to sanction

NOTES

10
8
6
5
4
3
2
1
0

0 1 2 3 4 5 6 8 10m Scale 1:100